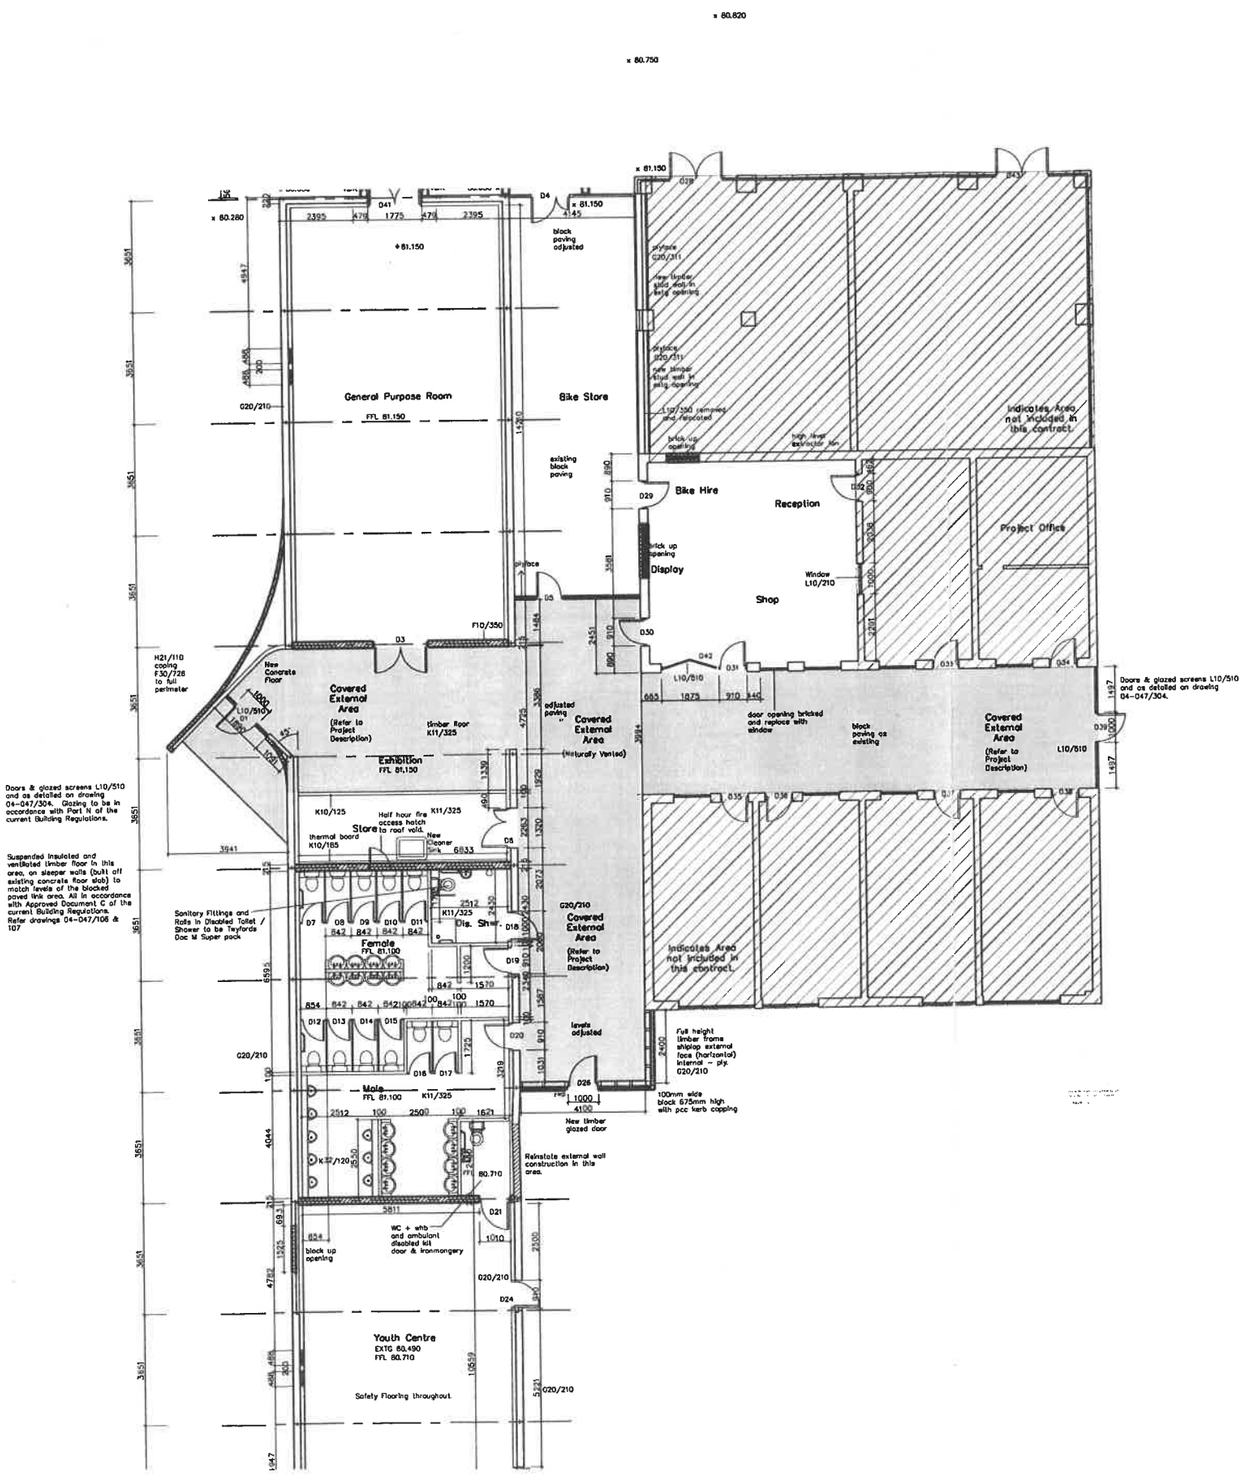

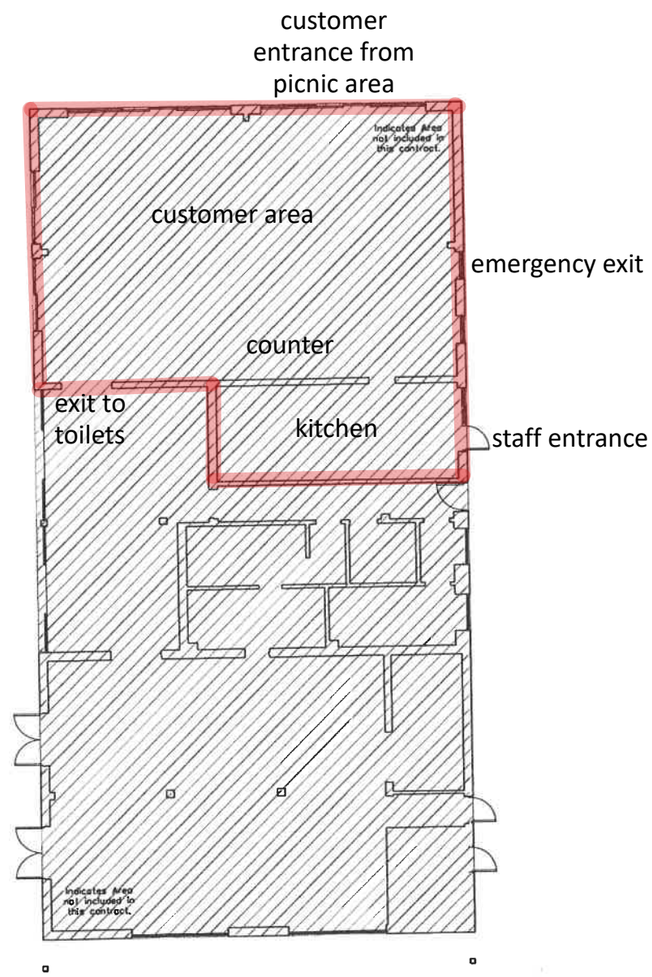

AS BUILT DRAWING

D 10.03.'06 EXTERNAL RAMPS & STEPS ADDED
C 27.09.'05 SCHOOL ENTRANCE LOBBY / TOILETS REVISED & DOOR/SCREEN D2 OMITTED
B 11.08.'05 DRAWING UPDATED & INFORMATION ADDED
A 13/06/05 Changes to storage frame, door dimensions and replace project office partition wall

Rodbaton Forestry Centre

Rodbaton Forestry Centre

Floor Plan

ROTHERA GOODWIN CHARTERED ARCHITECTS